

MD 22 IS ASSUMED TO RUN
IN AN EAST-WEST DIRECTION


PROPOSED VIDEO
DETECTION CAMERA

a,b,c




EXISTING SIGN
TO BE REMOVED

8A

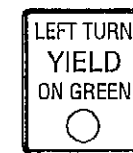


1A, 2A, 5A-7A

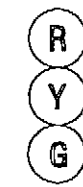


12"

3A

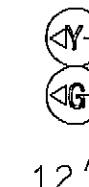

12" / 8"

4A

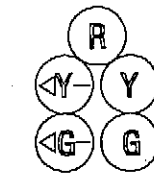


12"

EXISTING SIGNALS
TO BE REMOVED


PROPOSED SIGNALS

1, 2, 5-7

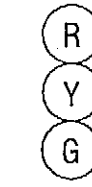


12"
L.E.D.

3

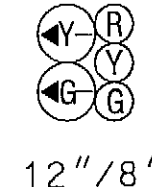


12" / 8"
L.E.D.

4

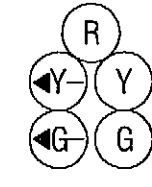

12"
L.E.D.

NEMA PHASING

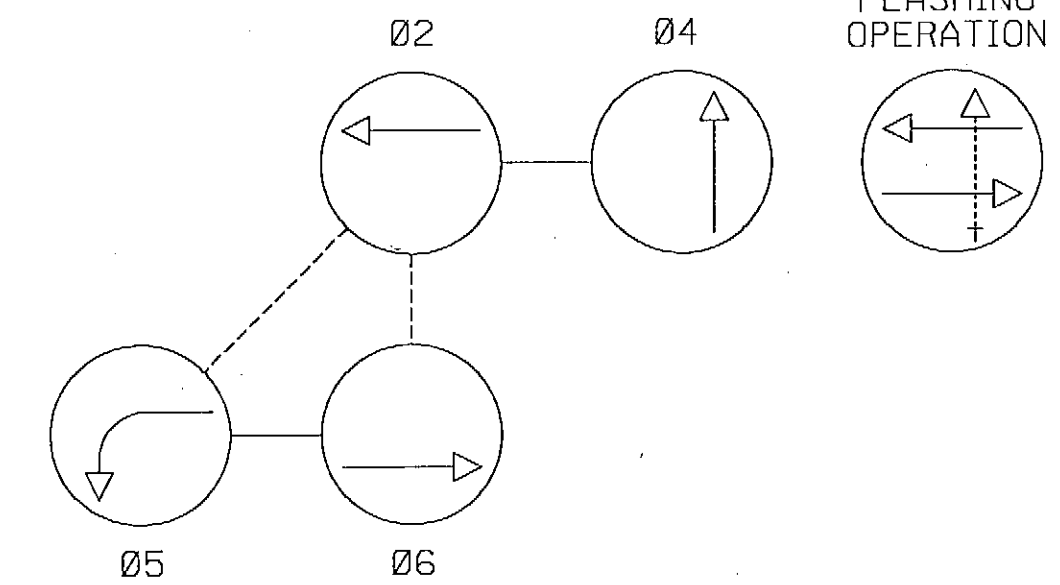


NOTE:
PHASES ASSOCIATED BY A DASHED LINE WILL OPERATE CONCURRENTLY.
PHASES ASSOCIATED BY A SOLID LINE WILL NOT OPERATE CONCURRENTLY.


SPECIAL NOTES:

1. DISCONNECT EXISTING ELECTRICAL CABLE FROM EXISTING SIGNAL HEADS TO BE REMOVED AND RE-CONNECT TO PROPOSED SIGNAL HEADS. ANY SIGNAL OUTAGE SHALL BE SCHEDULED DURING NON-PEAK HOURS AS DIRECTED BY THE ENGINEER.
2. INSTALL HANDHOLE WITH LONG DIMENSION PERPENDICULAR TO TRAVEL WAY FOR INSTALLATION OF NON-INVASIVE PROBES. EXTEND CONDUIT A MINIMUM OF 2 IN. AND MAXIMUM OF 3 IN. INTO HANDHOLE.

VIDEO ZONE
DETECTION

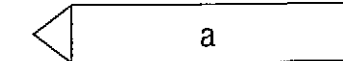

RIGHT OF WAY LINE

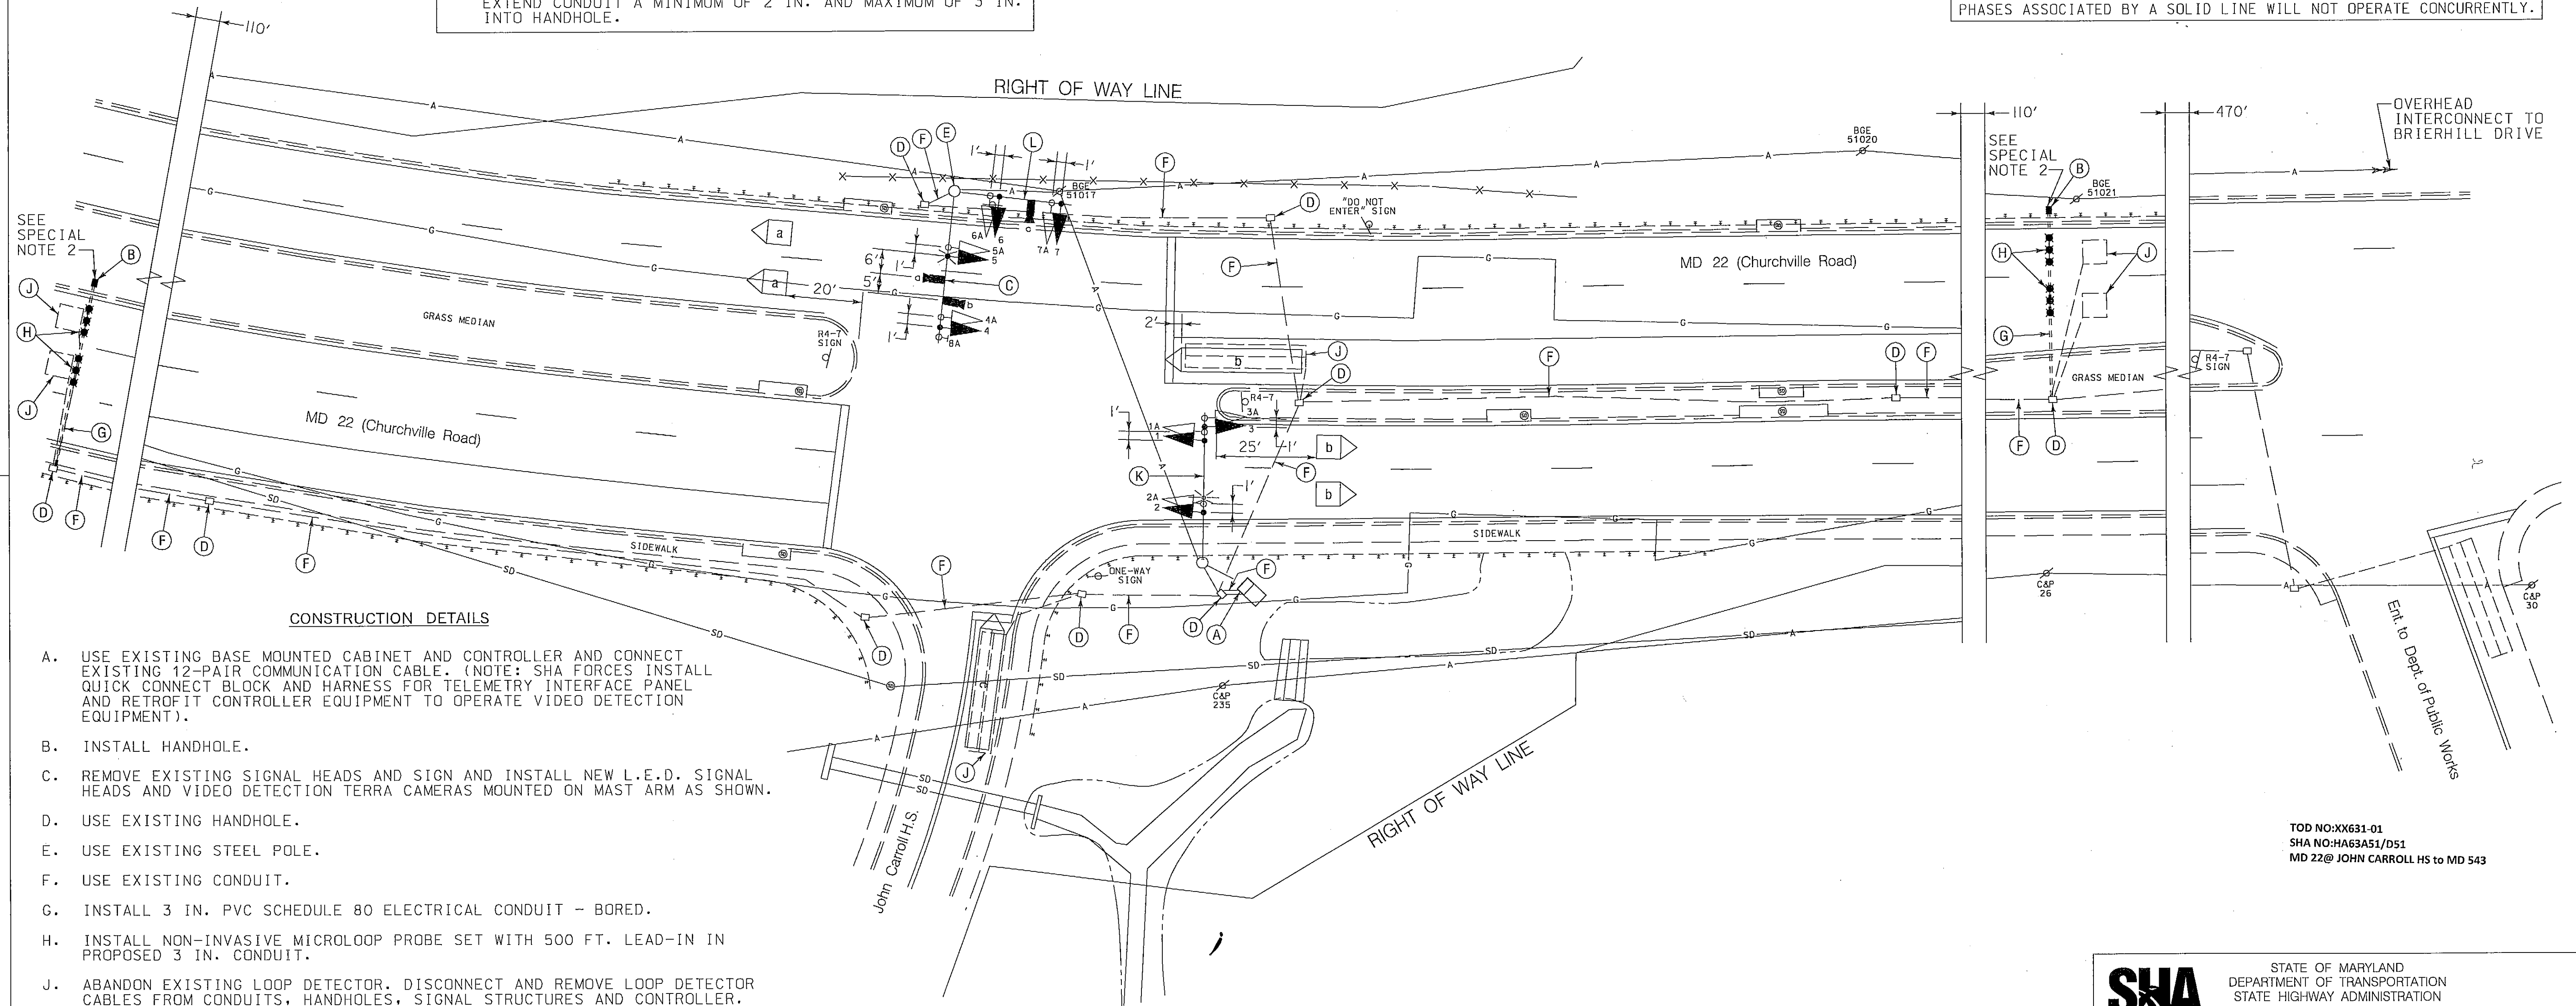

CONSTRUCTION DETAILS

- A. USE EXISTING BASE MOUNTED CABINET AND CONTROLLER AND CONNECT EXISTING 12-PAIR COMMUNICATION CABLE. (NOTE: SHA FORCES INSTALL QUICK CONNECT BLOCK AND HARNESS FOR TELEMETRY INTERFACE PANEL AND RETROFIT CONTROLLER EQUIPMENT TO OPERATE VIDEO DETECTION EQUIPMENT).
- B. INSTALL HANDHOLE.
- C. REMOVE EXISTING SIGNAL HEADS AND SIGN AND INSTALL NEW L.E.D. SIGNAL HEADS AND VIDEO DETECTION TERRA CAMERAS MOUNTED ON MAST ARM AS SHOWN.
- D. USE EXISTING HANDHOLE.
- E. USE EXISTING STEEL POLE.
- F. USE EXISTING CONDUIT.
- G. INSTALL 3 IN. PVC SCHEDULE 80 ELECTRICAL CONDUIT - BORED.
- H. INSTALL NON-INVASIVE MICROLOOP PROBE SET WITH 500 FT. LEAD-IN IN PROPOSED 3 IN. CONDUIT.
- J. ABANDON EXISTING LOOP DETECTOR. DISCONNECT AND REMOVE LOOP DETECTOR CABLES FROM CONDUITS, HANDHOLES, SIGNAL STRUCTURES AND CONTROLLER.
- K. REMOVE EXISTING SIGNAL HEADS AND INSTALL NEW L.E.D. SIGNAL HEADS AS SHOWN.
- L. REMOVE EXISTING SIGNAL HEADS AND INSTALL NEW L.E.D. SIGNAL HEADS AND VIDEO DETECTION TERRA CAMERA MOUNTED ON MAST ARM AS SHOWN.

GENERAL NOTES

1. ALL EXISTING TRAFFIC SIGNAL EQUIPMENT REMOVED SHALL BECOME THE PROPERTY OF THE SIGNAL CONTRACTOR UPON COMPLETION OF THE NEW SIGNAL.
2. THE CONTRACTOR SHALL BE RESPONSIBLE FOR TERMINATING ALL SIGNAL CABLE TO THE APPROPRIATE TERMINALS AND PROPERLY LABEL EACH CABLE.
3. VIDEO CAMERA LOCATION / ALIGNING SHALL BE COORDINATED WITH THE SHA ENGINEER.
4. THE CONTRACTOR SHALL VERIFY ALL UNDERGROUND UTILITIES PRIOR TO INSTALLING PROPOSED SIGNAL EQUIPMENT. IF ANY UTILITY CONFLICTS SHOULD ARISE THE CONTRACTOR SHALL CONTACT THE PROJECT ENGINEER.
5. ALL HANDHOLES SHALL BE INSTALLED AT FINAL GRADE.
6. REMOVE AND DISPOSE OF ALL UNUSED SIGNAL CABLE.

GEOMETRIC LEGEND

— EXISTING
— PROPOSED

UTILITY LEGEND

— SD — STORM DRAIN
— G — GAS MAIN
— W — WATER MAIN
— S — SEWER MAIN
— E — ELECTRIC CABLES
— A — AERIAL CABLES
— T — TELEPHONE CABLES
— F — FIBER-OPTIC

WR&A

Whitman, Requardt and Associates, LLP
Engineers, Architects and Planners

801 South Caroline Street
Baltimore, Maryland 21231
410-235-3450

BY: sbloss

APPROVALS	
TEAM LEADER	
ASST. DIR. CHIEF	
DIVISION CHIEF	
OFFICE DIRECTOR	

REVISIONS	
P	UPGRADE SIGNAL HEADS TO LED AND CONNECTED INTERCONNECT 3/16/2009 SHA NO. XX6315105 TMS NO. 0780
G	ADDED LOOP DET. AT BEL AIR DEPT. OF PUBLIC WORKS AND INTERCONNECT SHA NO. H556-602-471 07/1994
WA	BT ETP TH
D	AS BUILT
WM	
	4/1992

SHA STATE OF MARYLAND DEPARTMENT OF TRANSPORTATION STATE HIGHWAY ADMINISTRATION OFFICE OF TRAFFIC & SAFETY TRAFFIC ENGINEERING DESIGN DIVISION MD 22 (Churchville Road) and John Carroll High School Churchville, MD	
TRAFFIC SIGNALIZATION PLAN	
SCALE: 1" = 20' ADVERTISED DATE: 9/25/1978 CONTRACT NO.: H-782-501-485	
DESIGNED BY: Bruce Thompson	COUNTY: HARFORD
DRAWN BY: Bruce Thompson	LOGMILE: 12002200.76
CHECKED BY: D. Zeliris	TMS NO.: G780
F.A.P. NO.: SEE TITLE SHEET	TOD NO.:
TS NO. 1624 F	DRAWING TSP-1 OF 12
SHEET NO. 1 OF 12	

PLOTTED: 03-23-2009
FILE: m:\3156-157\CADD\p8g-p001_md22.dgn